Copyright © 2005 Cartomation Inc.

107 4626

BREAKERS CONDOMINIUM PHASE 1

AS BUILT - SECOND FLOOR PLAN

BUILDING A

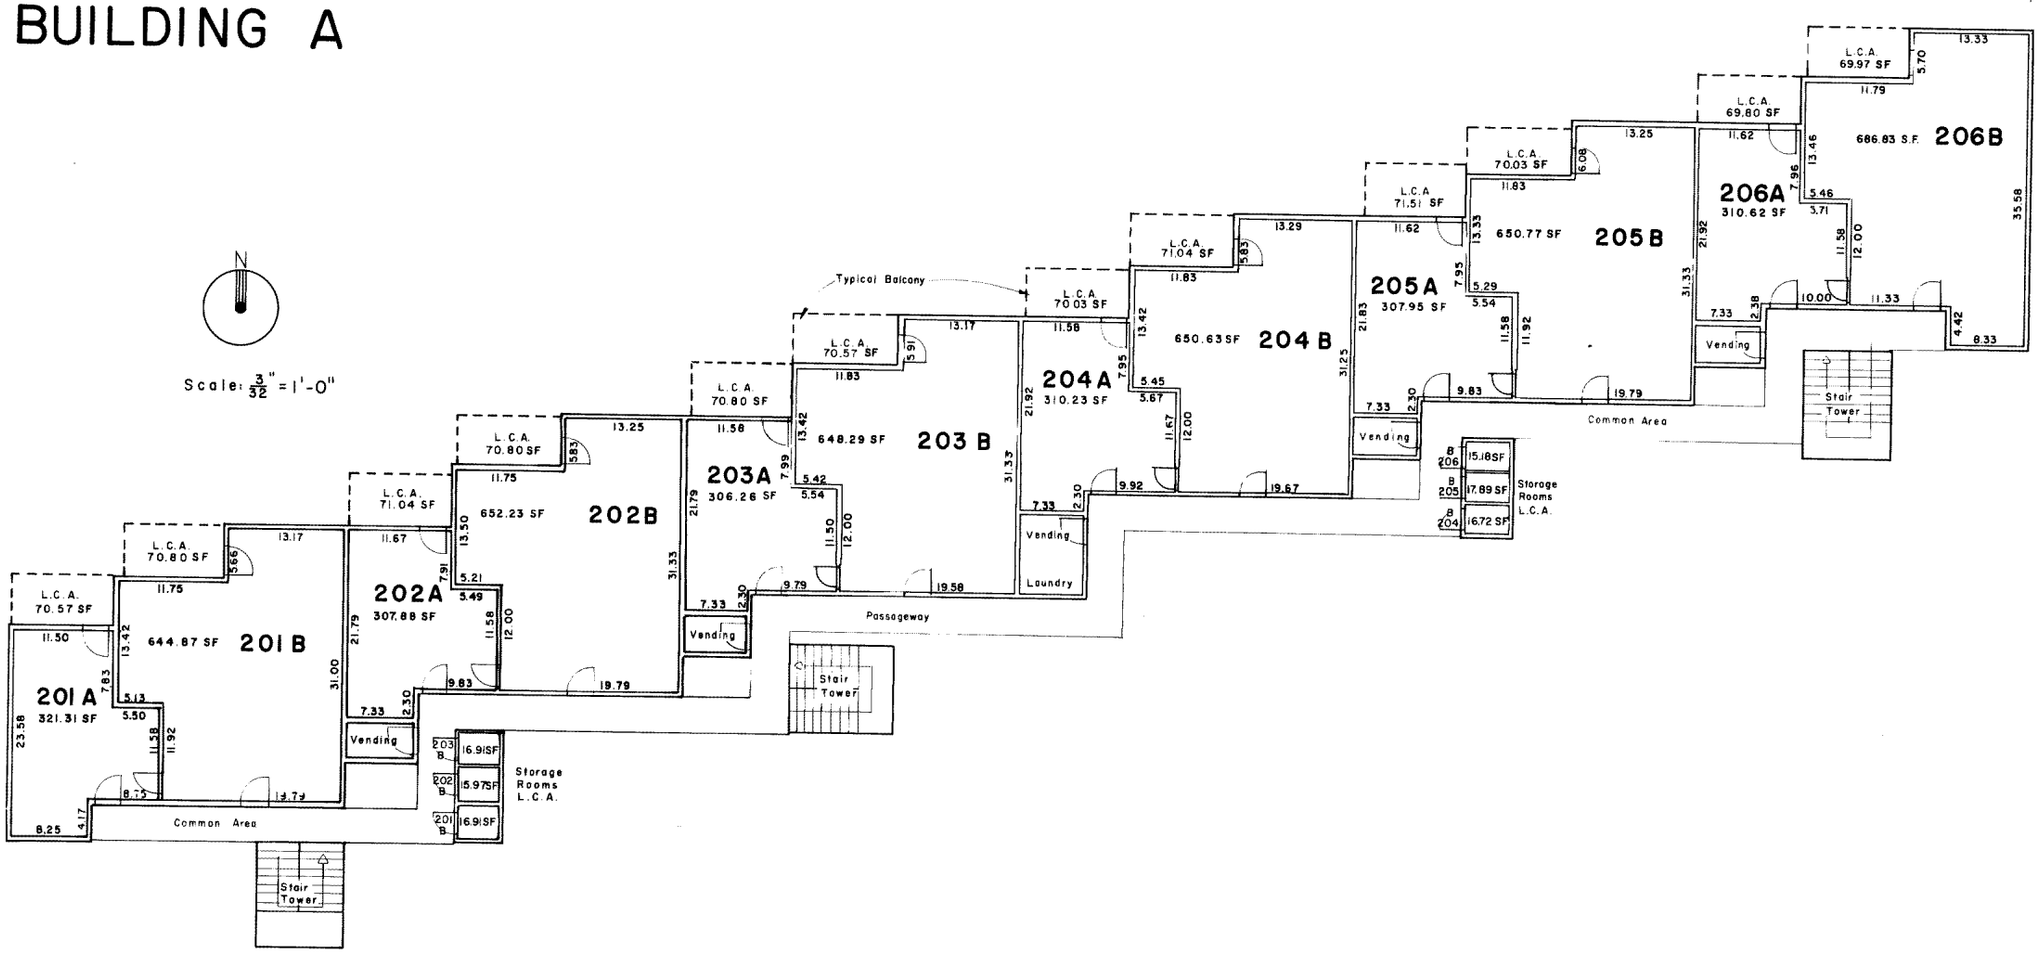

Haner, Ross & Sporseen, Inc.