Copyright © 2005 Cartomation Inc.

1074626

BREAKERS CONDOMINIUM PHASE 1

AS BUILT - THIRD FLOOR PLAN

BUILDING A

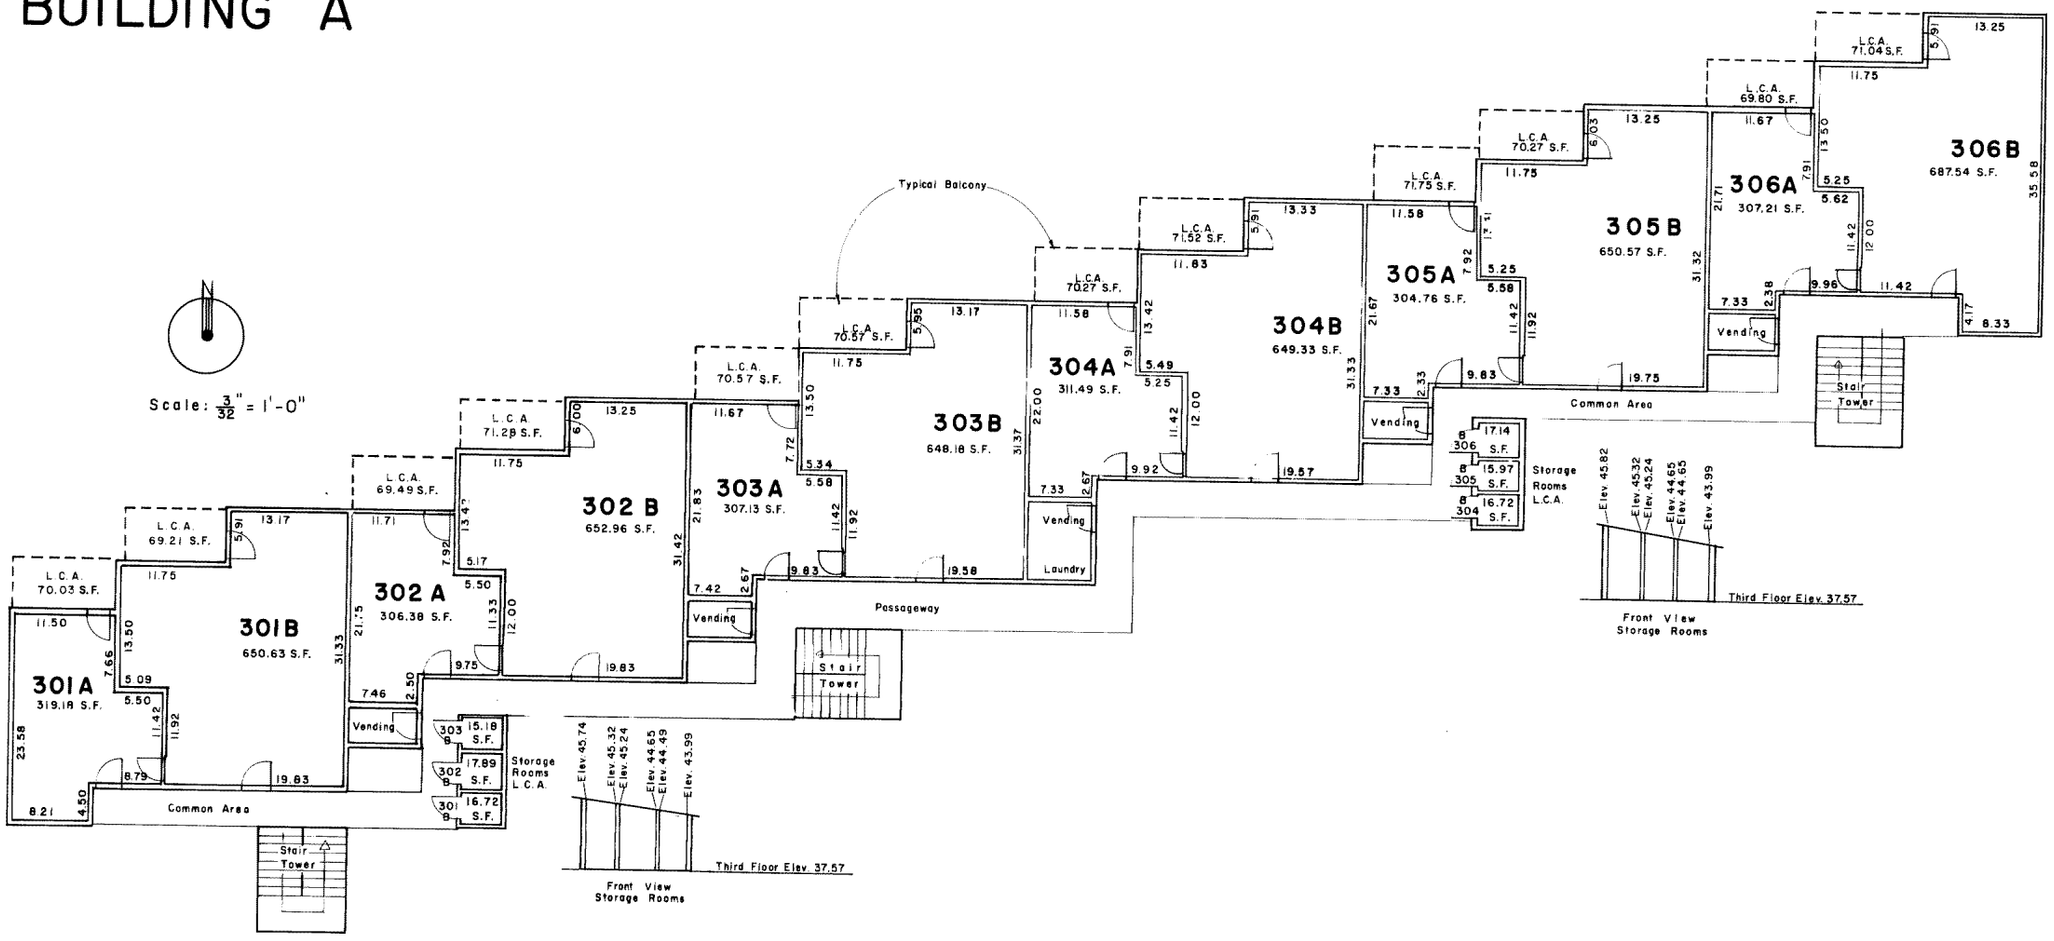

Haner, Ross & Sporseen, Inc.