Copyright © 2005 Cartomation Inc.

1074626 40

BREAKERS CONDOMINIUM PHASE 1

AS BUILT - SECOND FLOOR PLAN

BUILDING B

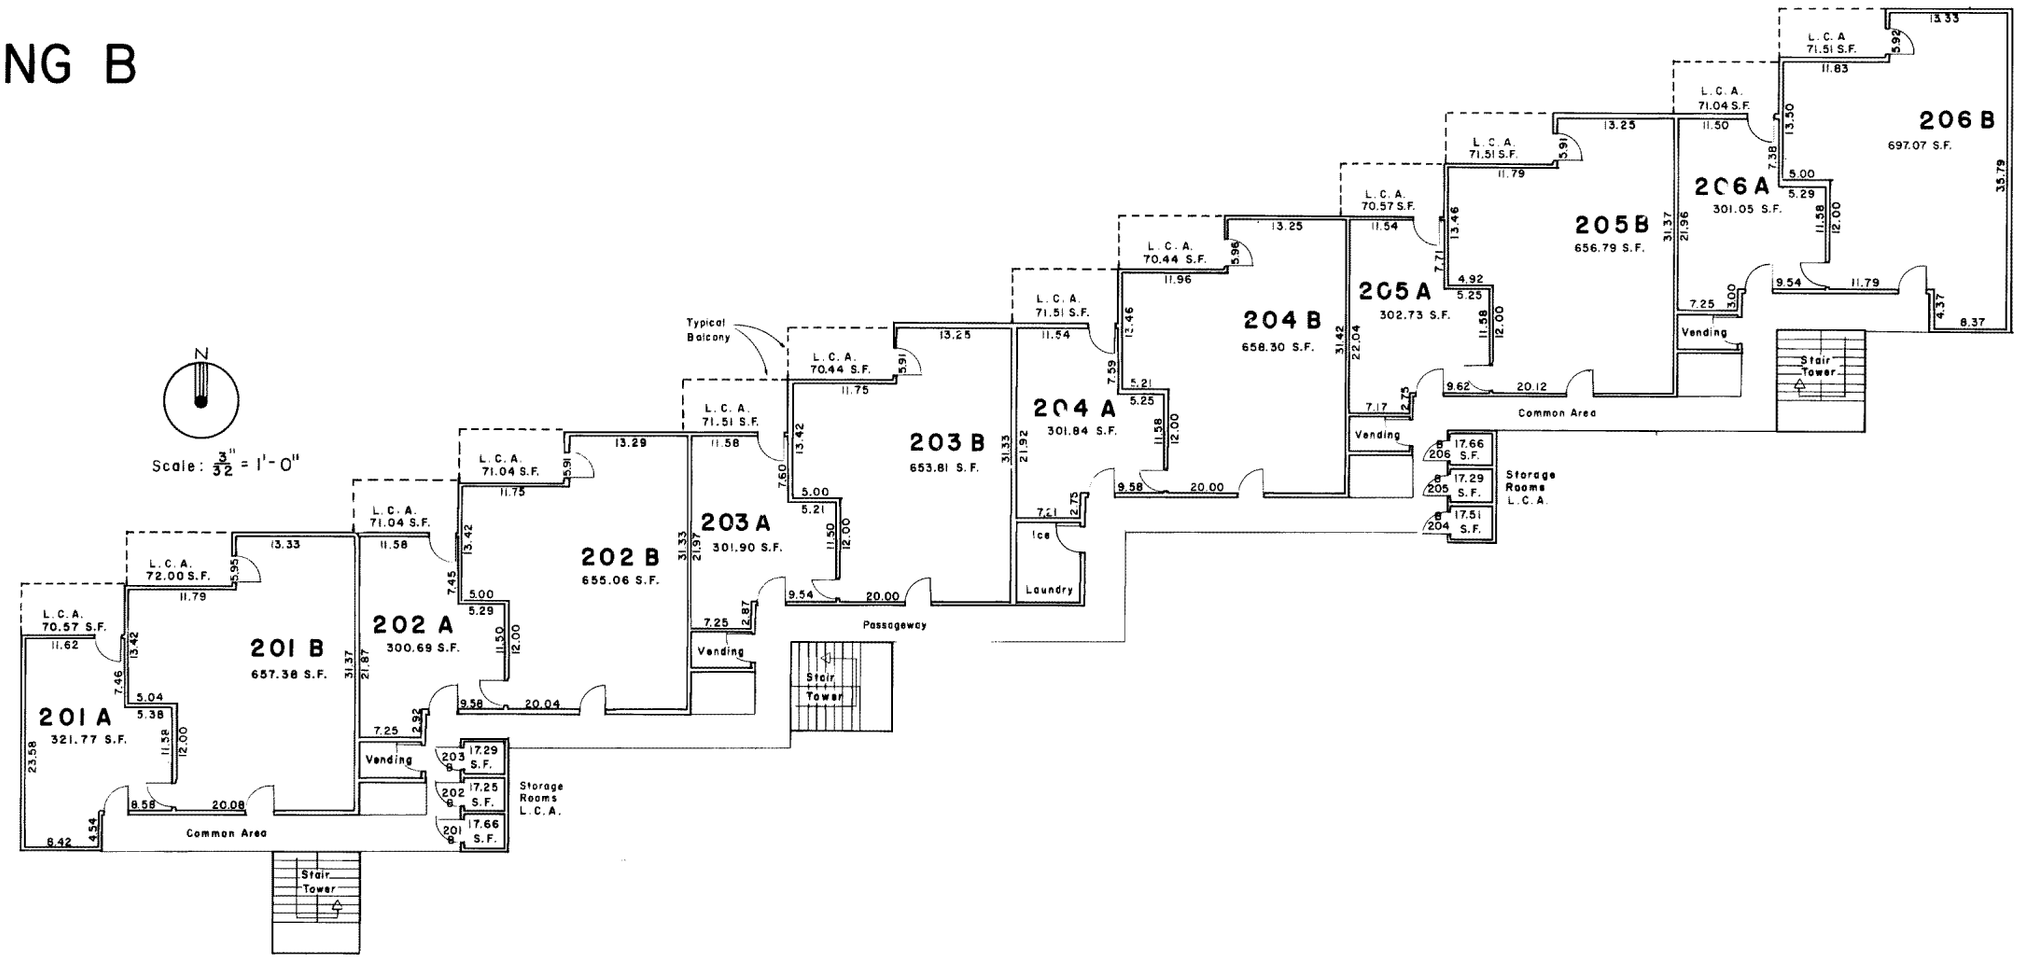

Haner, Ross & Sporseen, Inc.