Copyright © 2005 Cartomation Inc.

5 1074631

BREAKERS CONDOMINIUM PHASE II

AS BUILT - SECOND FLOOR PLAN

BUILDING C

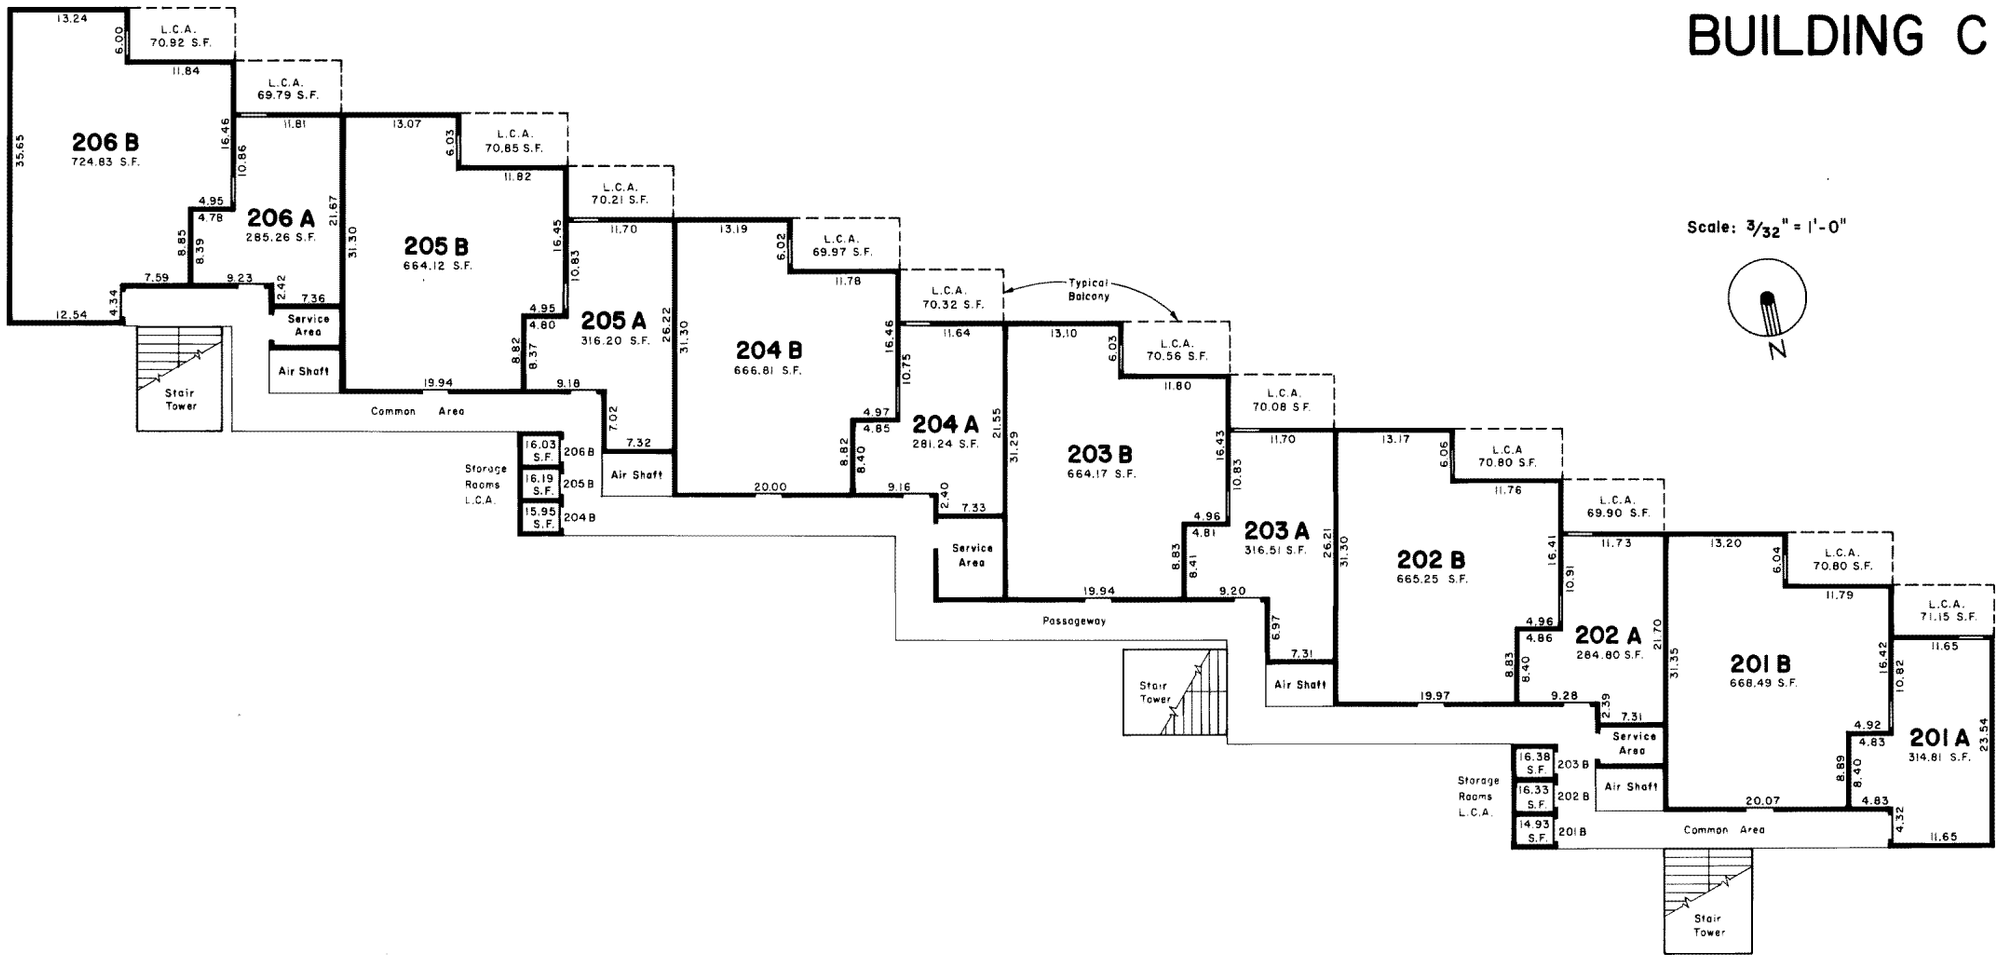

Haner, Ross & Sporseen, Inc.