Copyright © 2005 Cartomation Inc.
1074626

39

BREAKERS CONDOMINIUM PHASE 1

AS BUILT - FIRST FLOOR PLAN

BUILDING B

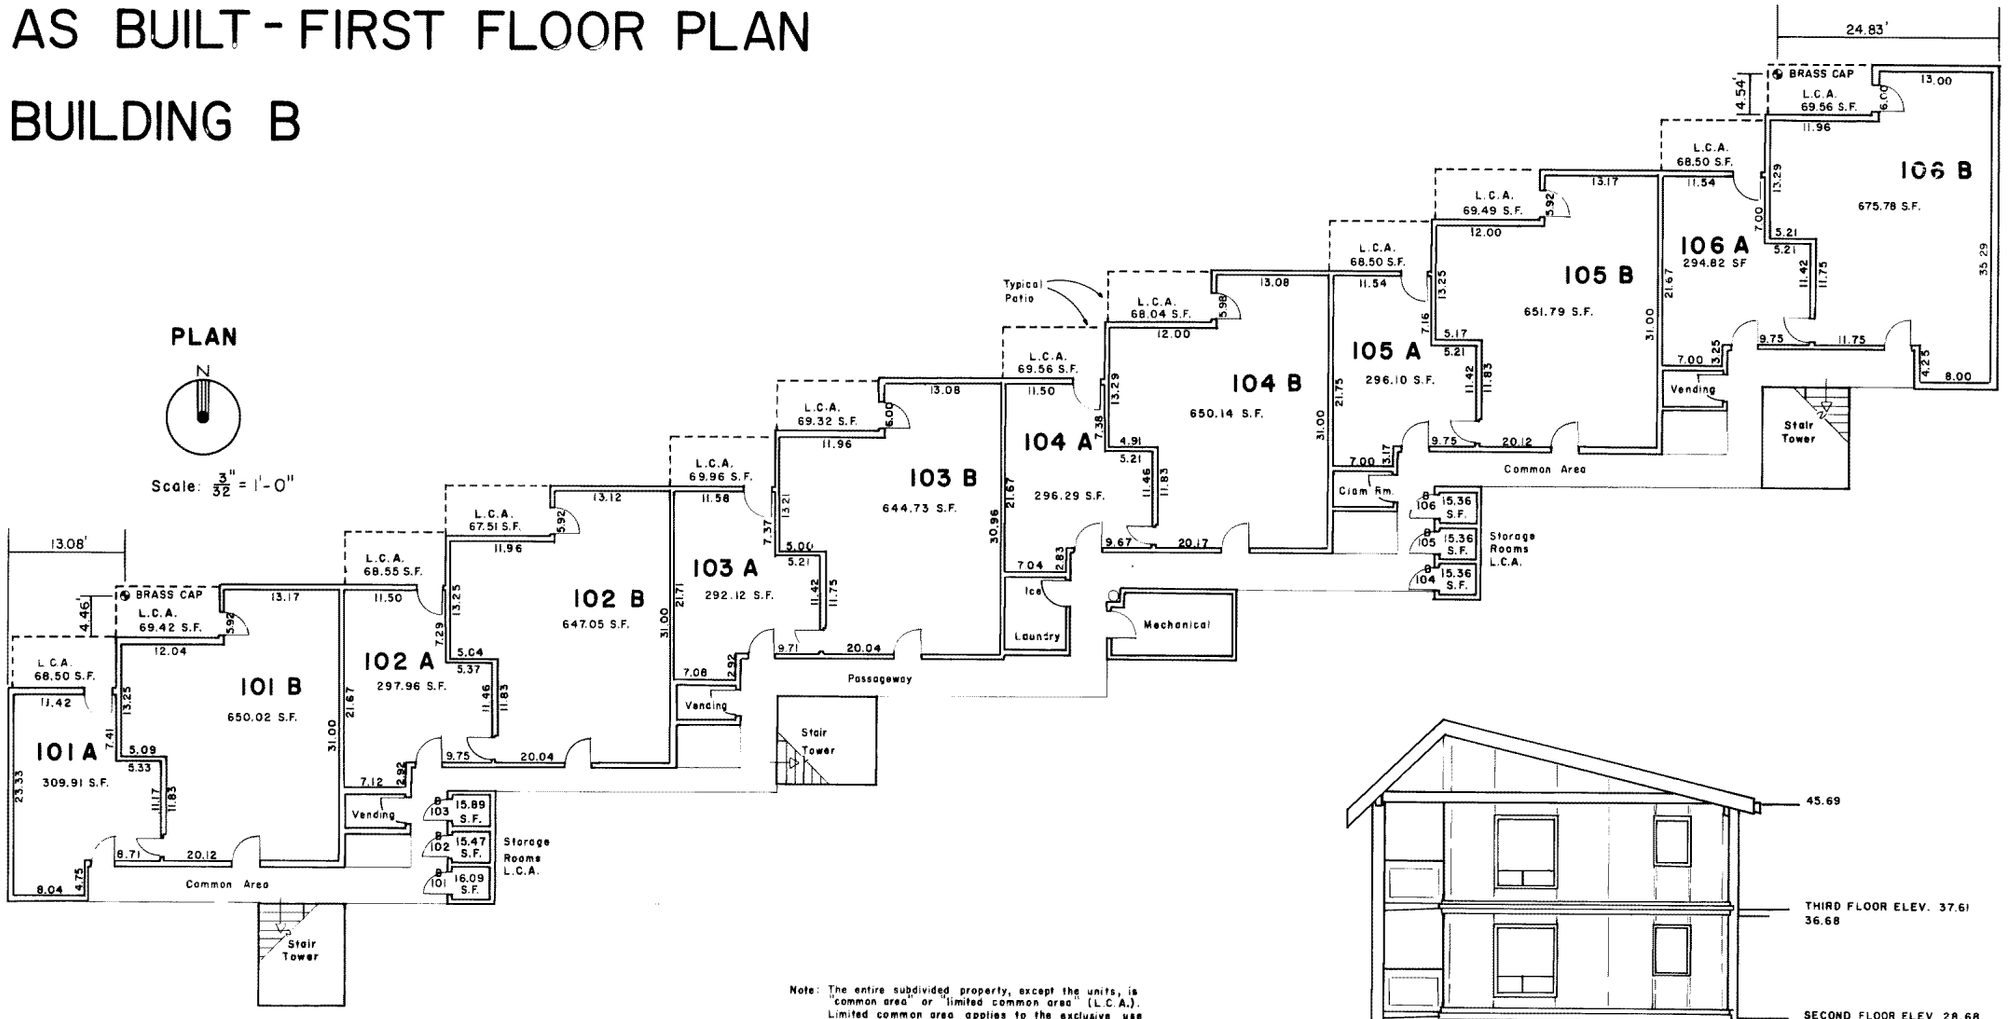

Note: The entire subdivided property, except the units, is "common area" or "limited common area" (L.C.A.). Limited common area applies to the exclusive use by the attached or assigned unit. Storage rooms are assigned to "B" units only.

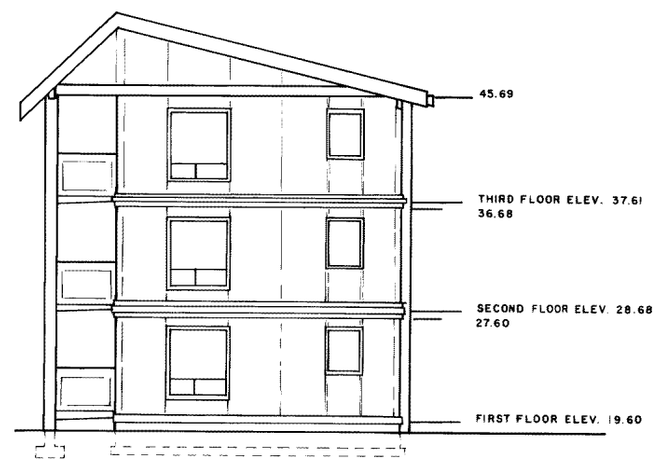

WEST ELEVATION
(Datum: U.S.C. & G.S. Mean Sea Level)

Haner, Ross & Sporseen, Inc.

Sheet 4 of 6